





AKED STREET

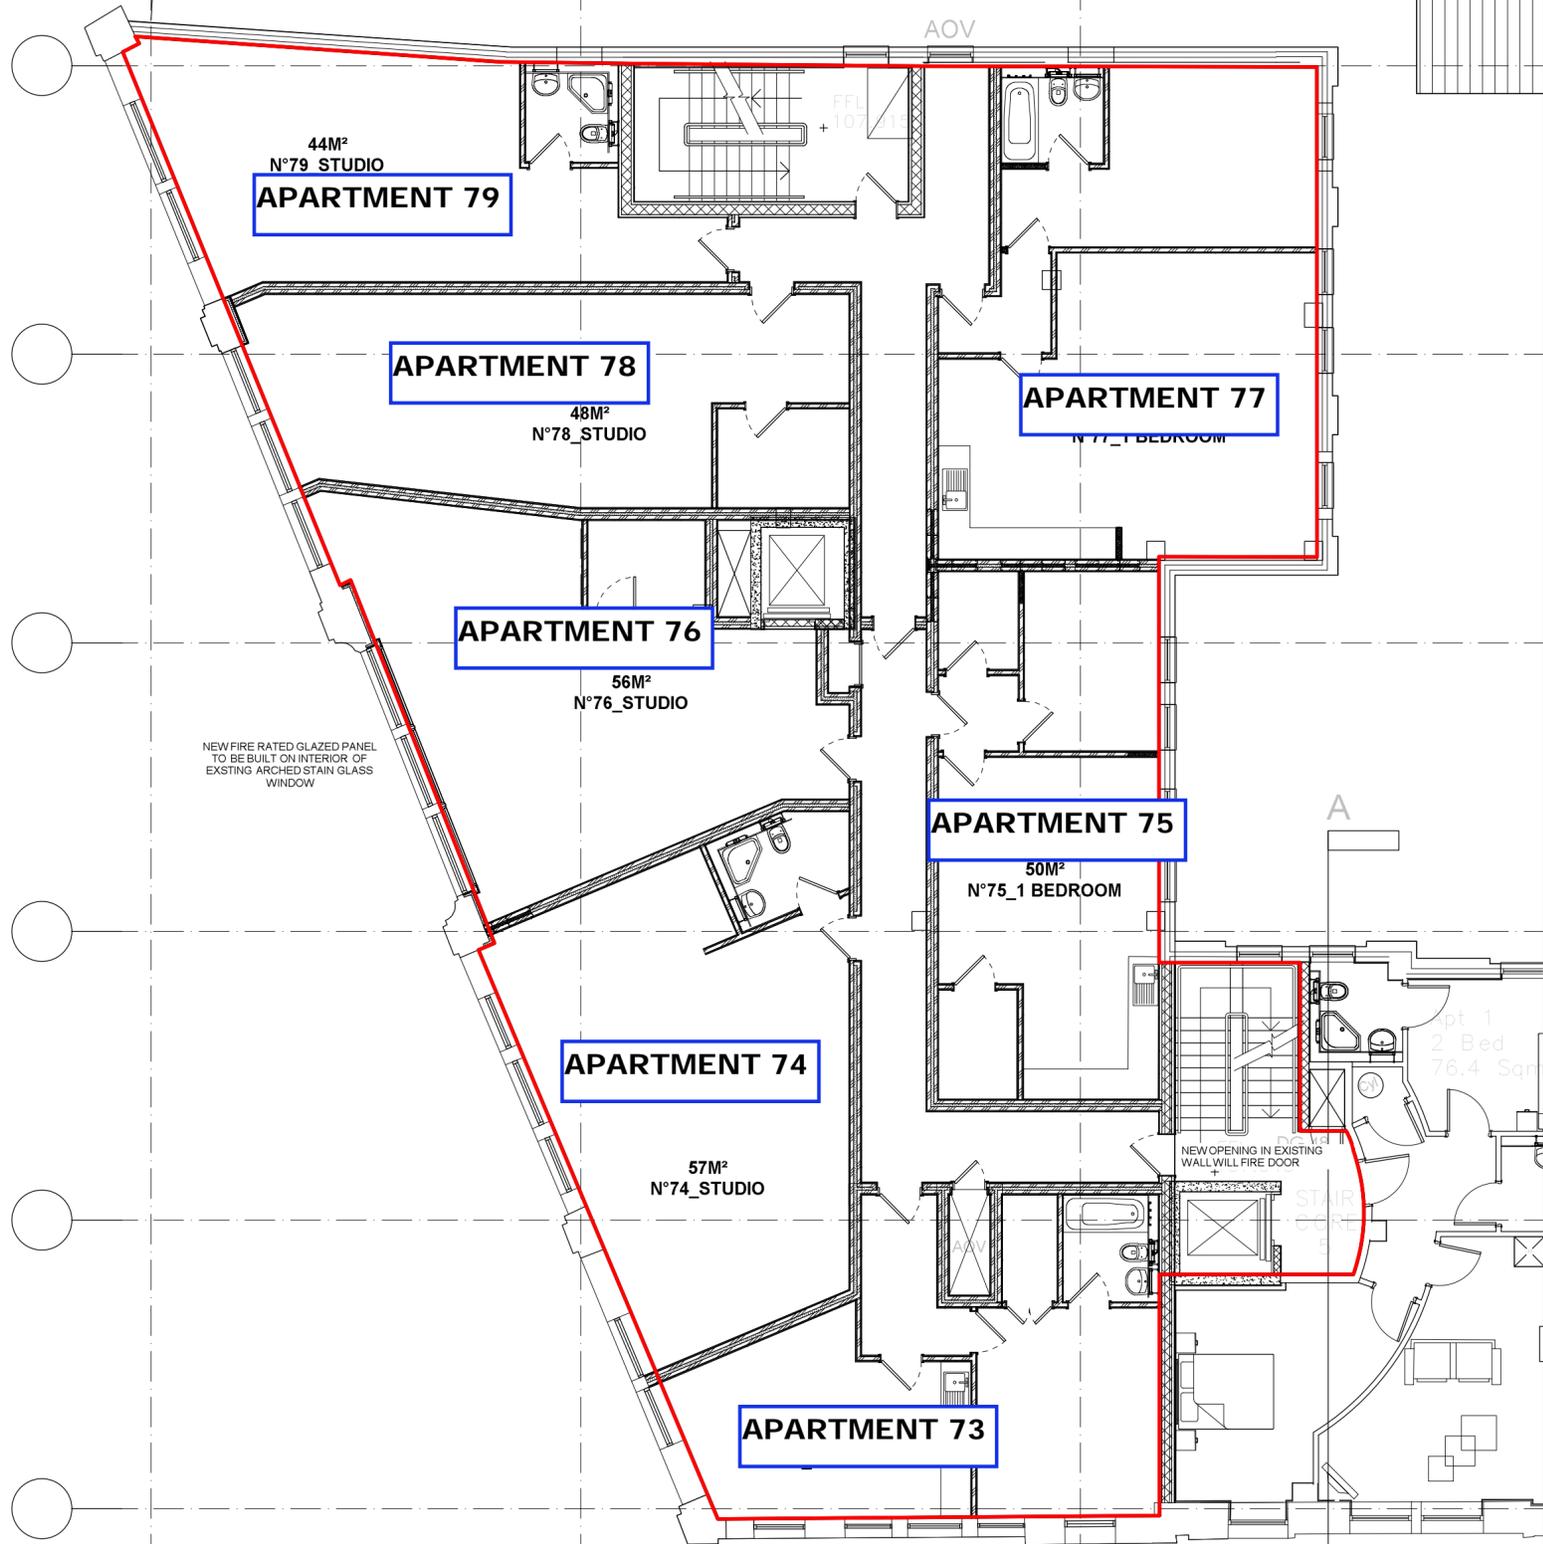


PARTIAL PLAN FIRST FLOOR PLAN_LEVEL 3

NOTES

CONTRACTOR TO CHECK ALL DIMENSIONS AND NOTIFY ARCHITECT AS SOON AS POSSIBLE FOR ANY DISCREPANCIES

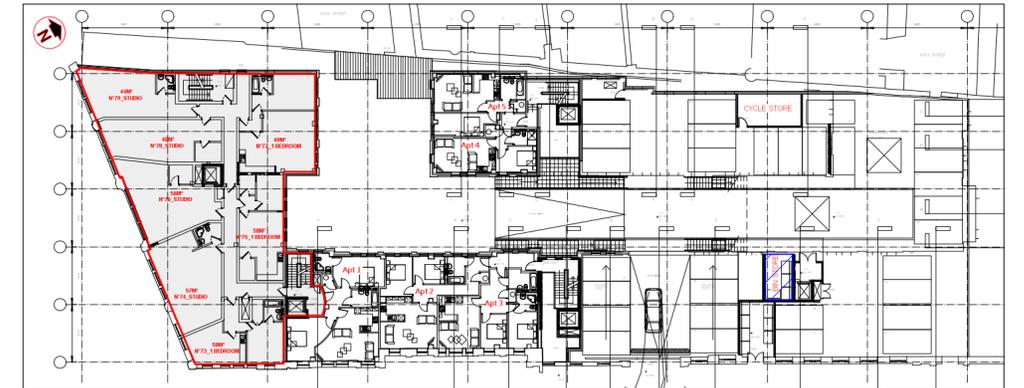

PLAN_FIRST FLOOR-LEVEL 3_1:500

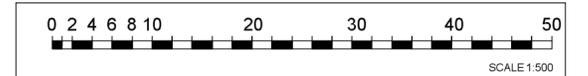

M & N BUILDERS PROPERTIES 3 LTD



APPARTMENTS:
EASTBROOK HALL
LITTLE GERMANY
BRADFORD BD1 5AE



Registered address:
7 Progress Business Centre
Whittle Way
Burnham
Berkshire
SL1 6DQ
usi@uslarchitects.co.uk

BUILDING REGULATIONS-AS BUILT

Job No	Date	Drawing
2022/EBH	07/08/2025	FIRST FLOOR LEVEL 3
Drn	Chk	Drawing Number
AA	BK	EBH/BR/102
Rev number	Rev date	Revision detail

This drawing is copyright USL Architects.

